

Ligne : Lausanne - Berne

Km 52'100

P.I. DE COTTENS

ROUTE CANTONALE FRIBOURG-ROMONT


ENSEMBLE

1:50

Conforme à l'exécution


CFF.I. SECTION DES PONTS			
Donnée	Projet	Approuvé	Contrôle
3.9.57	PM	dg	
a 5.9.57			
b 8.11.57			

COUPE DES MURS

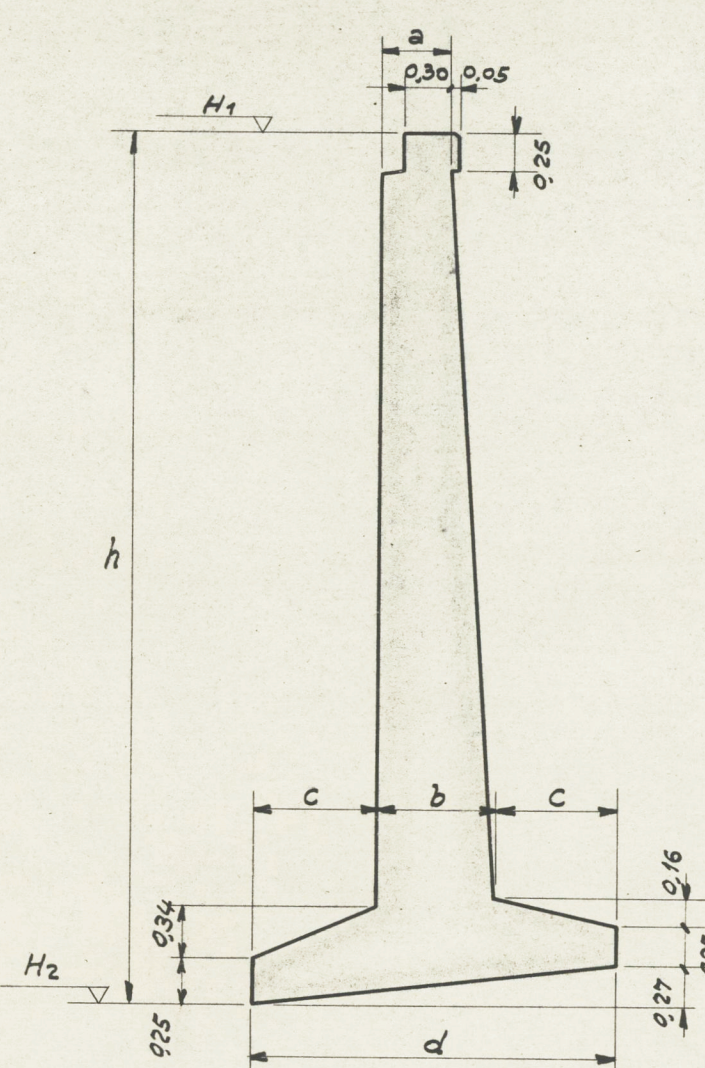


Coupe	h	a	b	c	d	H <sub>1</sub>	H <sub>2</sub>
H-H	3,12	0,208	0,46	0,60	1,675	708,16	705,04
J-J	6,31	0,50	0,815	0,80	2,415	711,35	705,04
K-K	3,68	0,382	0,82	0,60	1,785	708,69	705,04
L-L	6,31	0,50	0,815	0,80	2,415	711,35	705,04
M-M	6,77	0,54	0,875	0,80	2,475	711,48	704,71
N-N	2,60	0,30	0,43	0,60	1,63	707,31	704,71
O-O	4,58	0,50	0,83	0,80	2,43	711,48	704,90
P-P	5,20	0,41	0,67	0,68	2,05	710,10	704,90
R-R	4,40	0,37	0,59	0,60	1,79	709,30	704,90


VUE EN PLAN 1:50

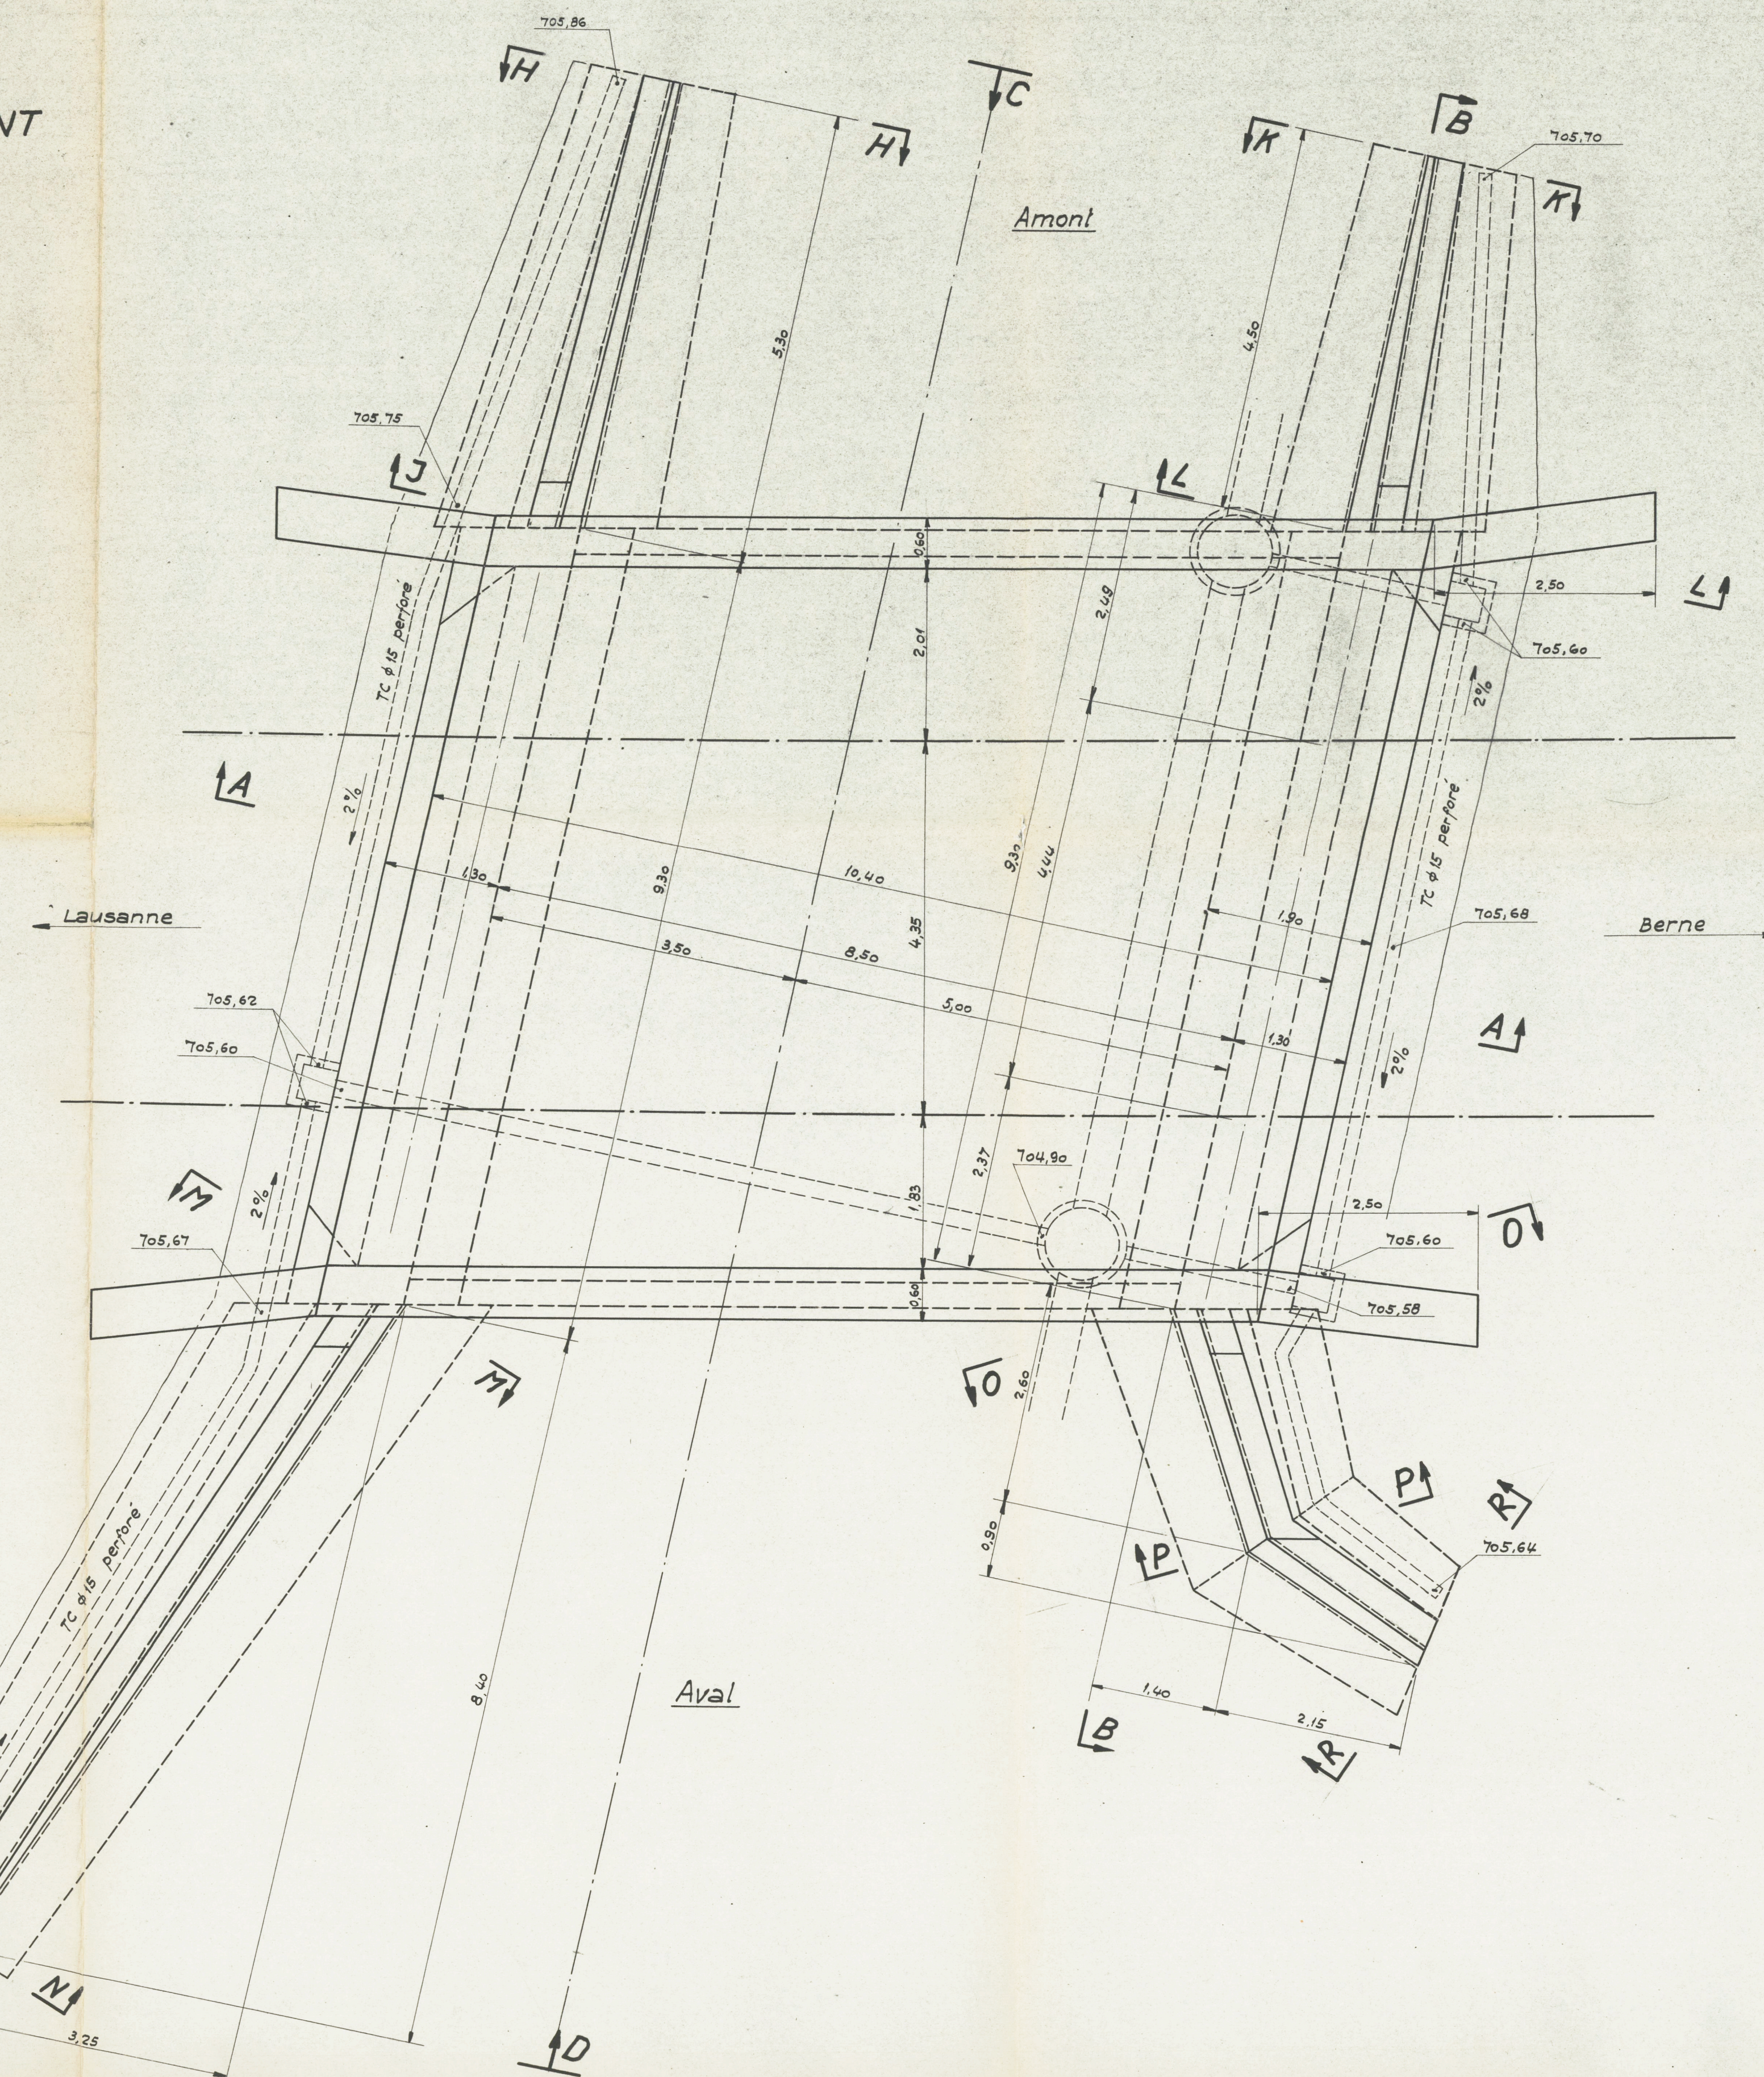


COUPE A-A 1:50

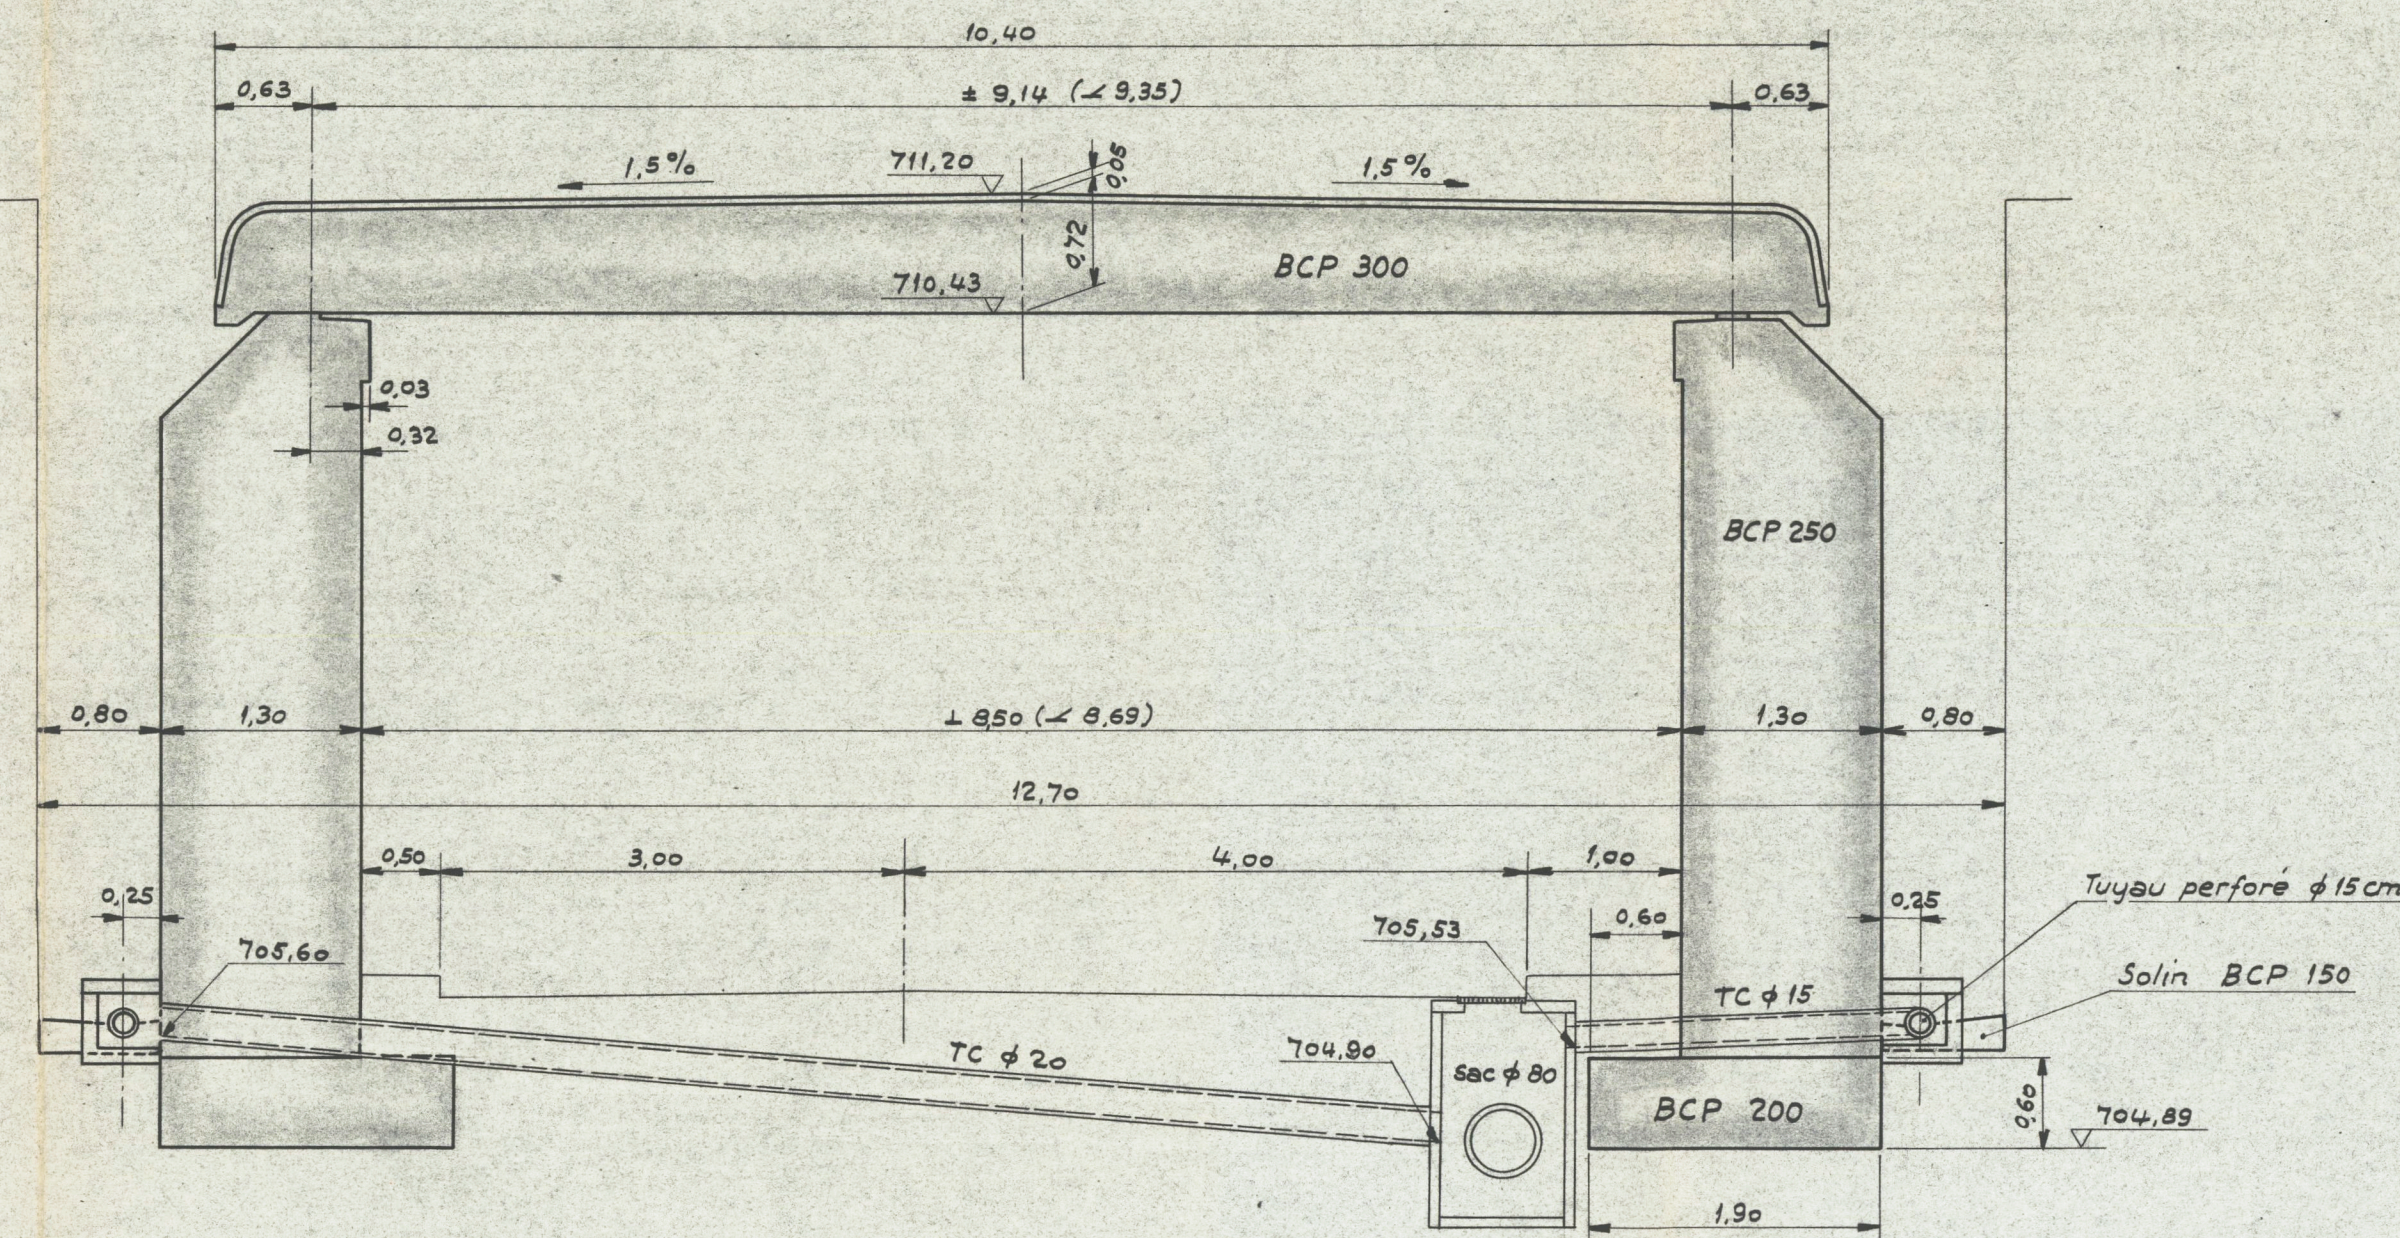


ELEVATION D 1:50

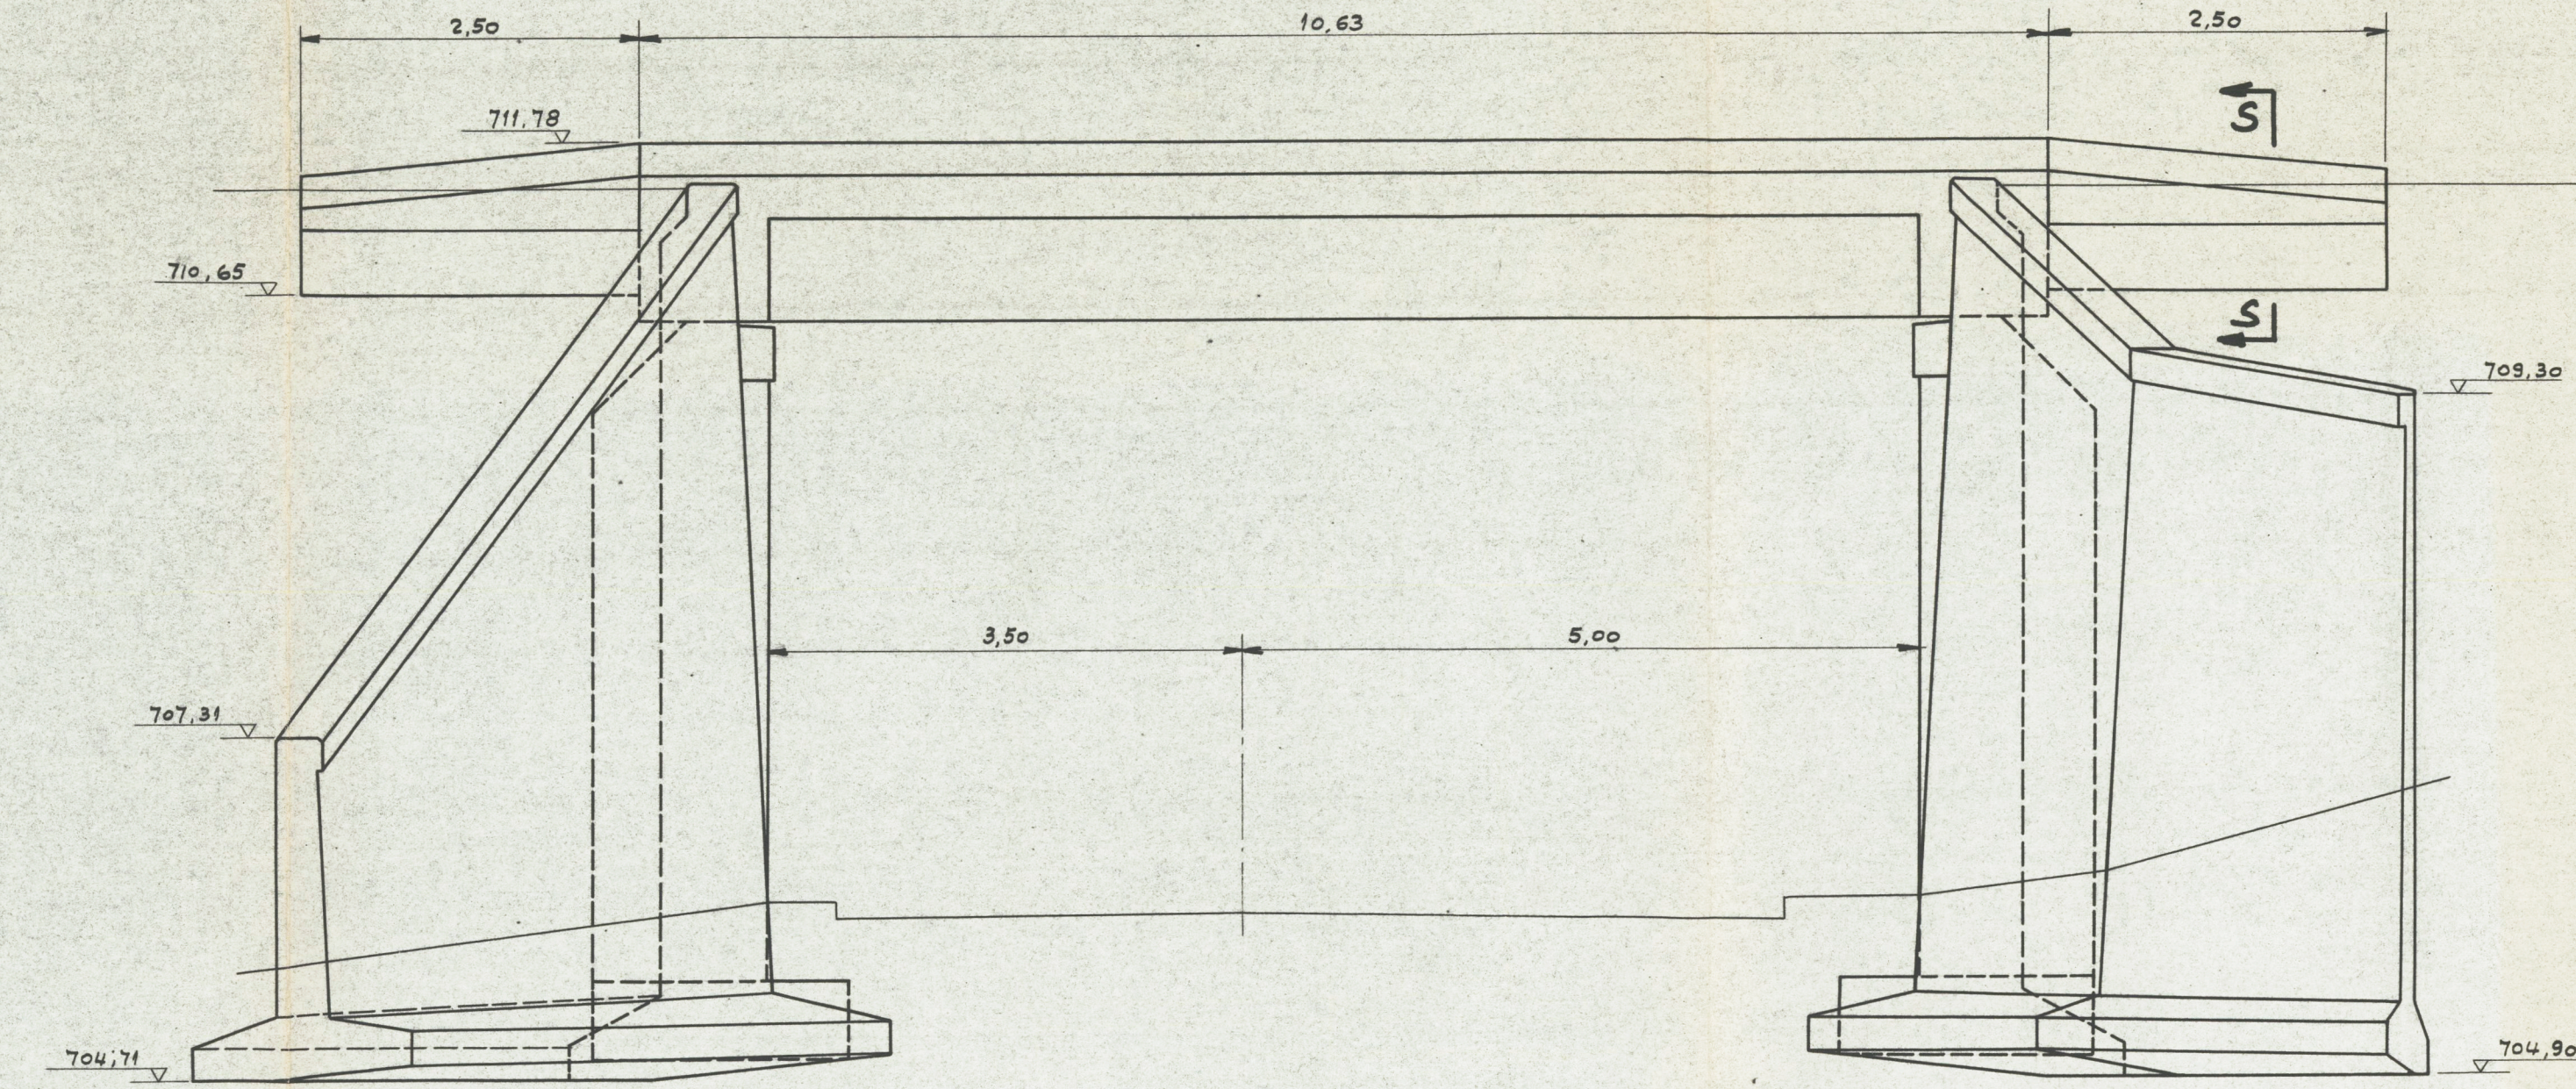


COUPE S-S 1:20

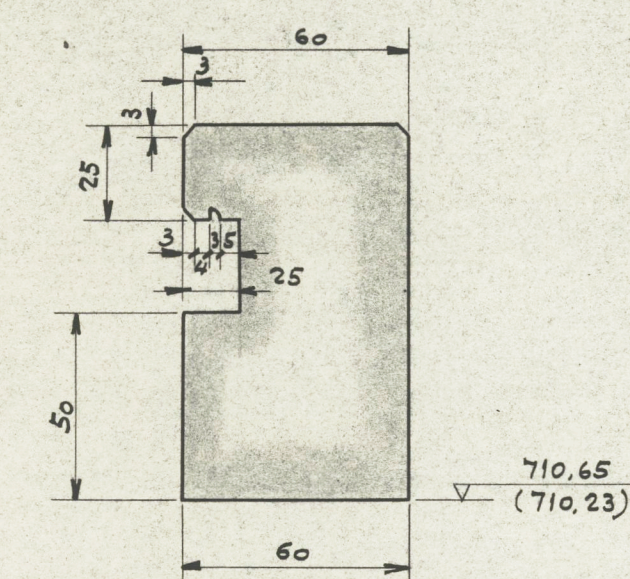


COUPE B-B 1:50

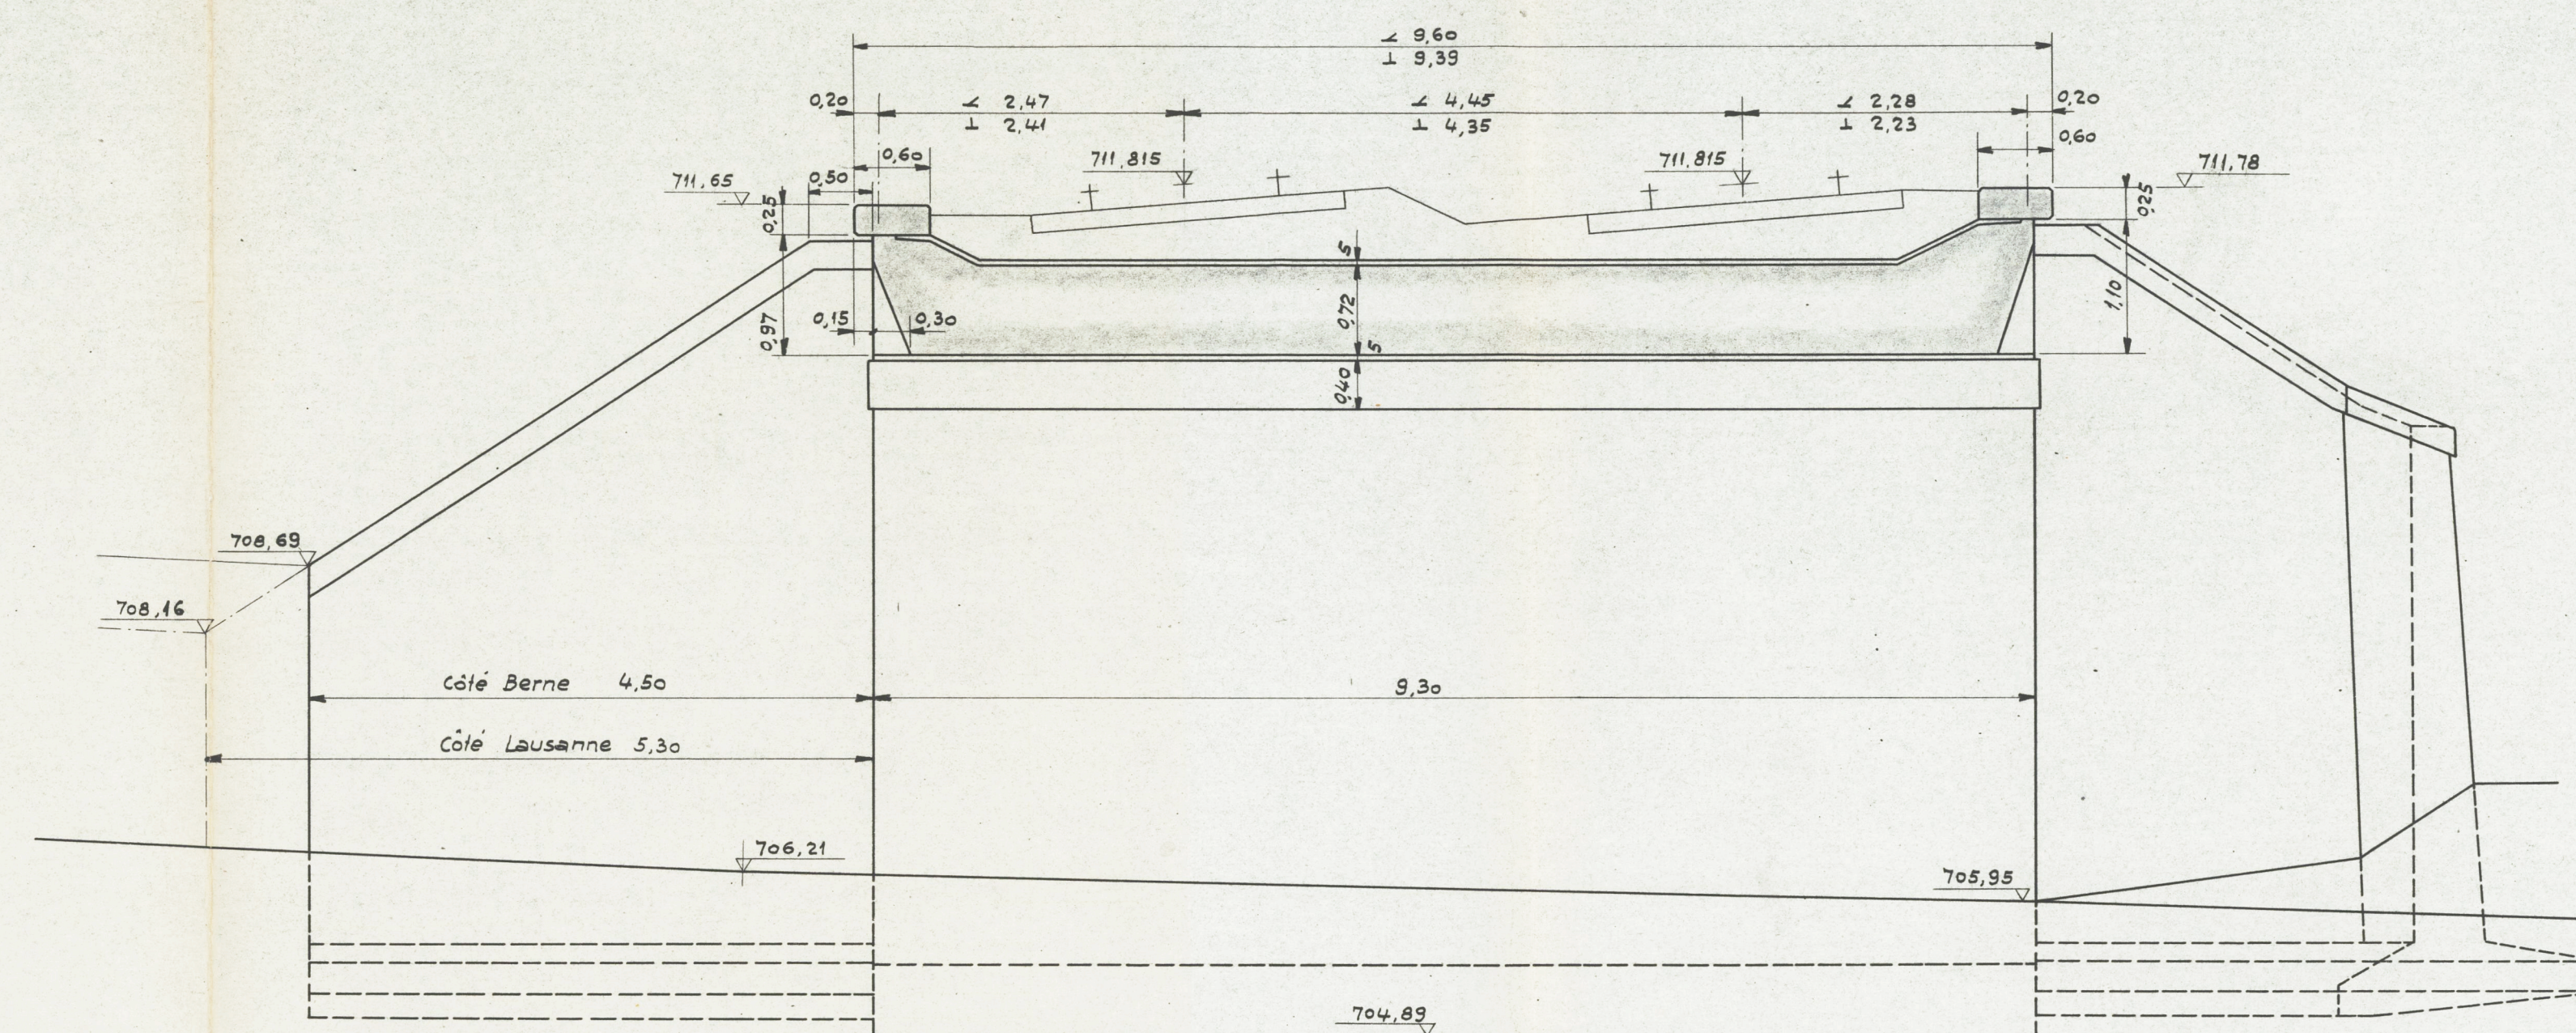


ELEVATION C 1:50

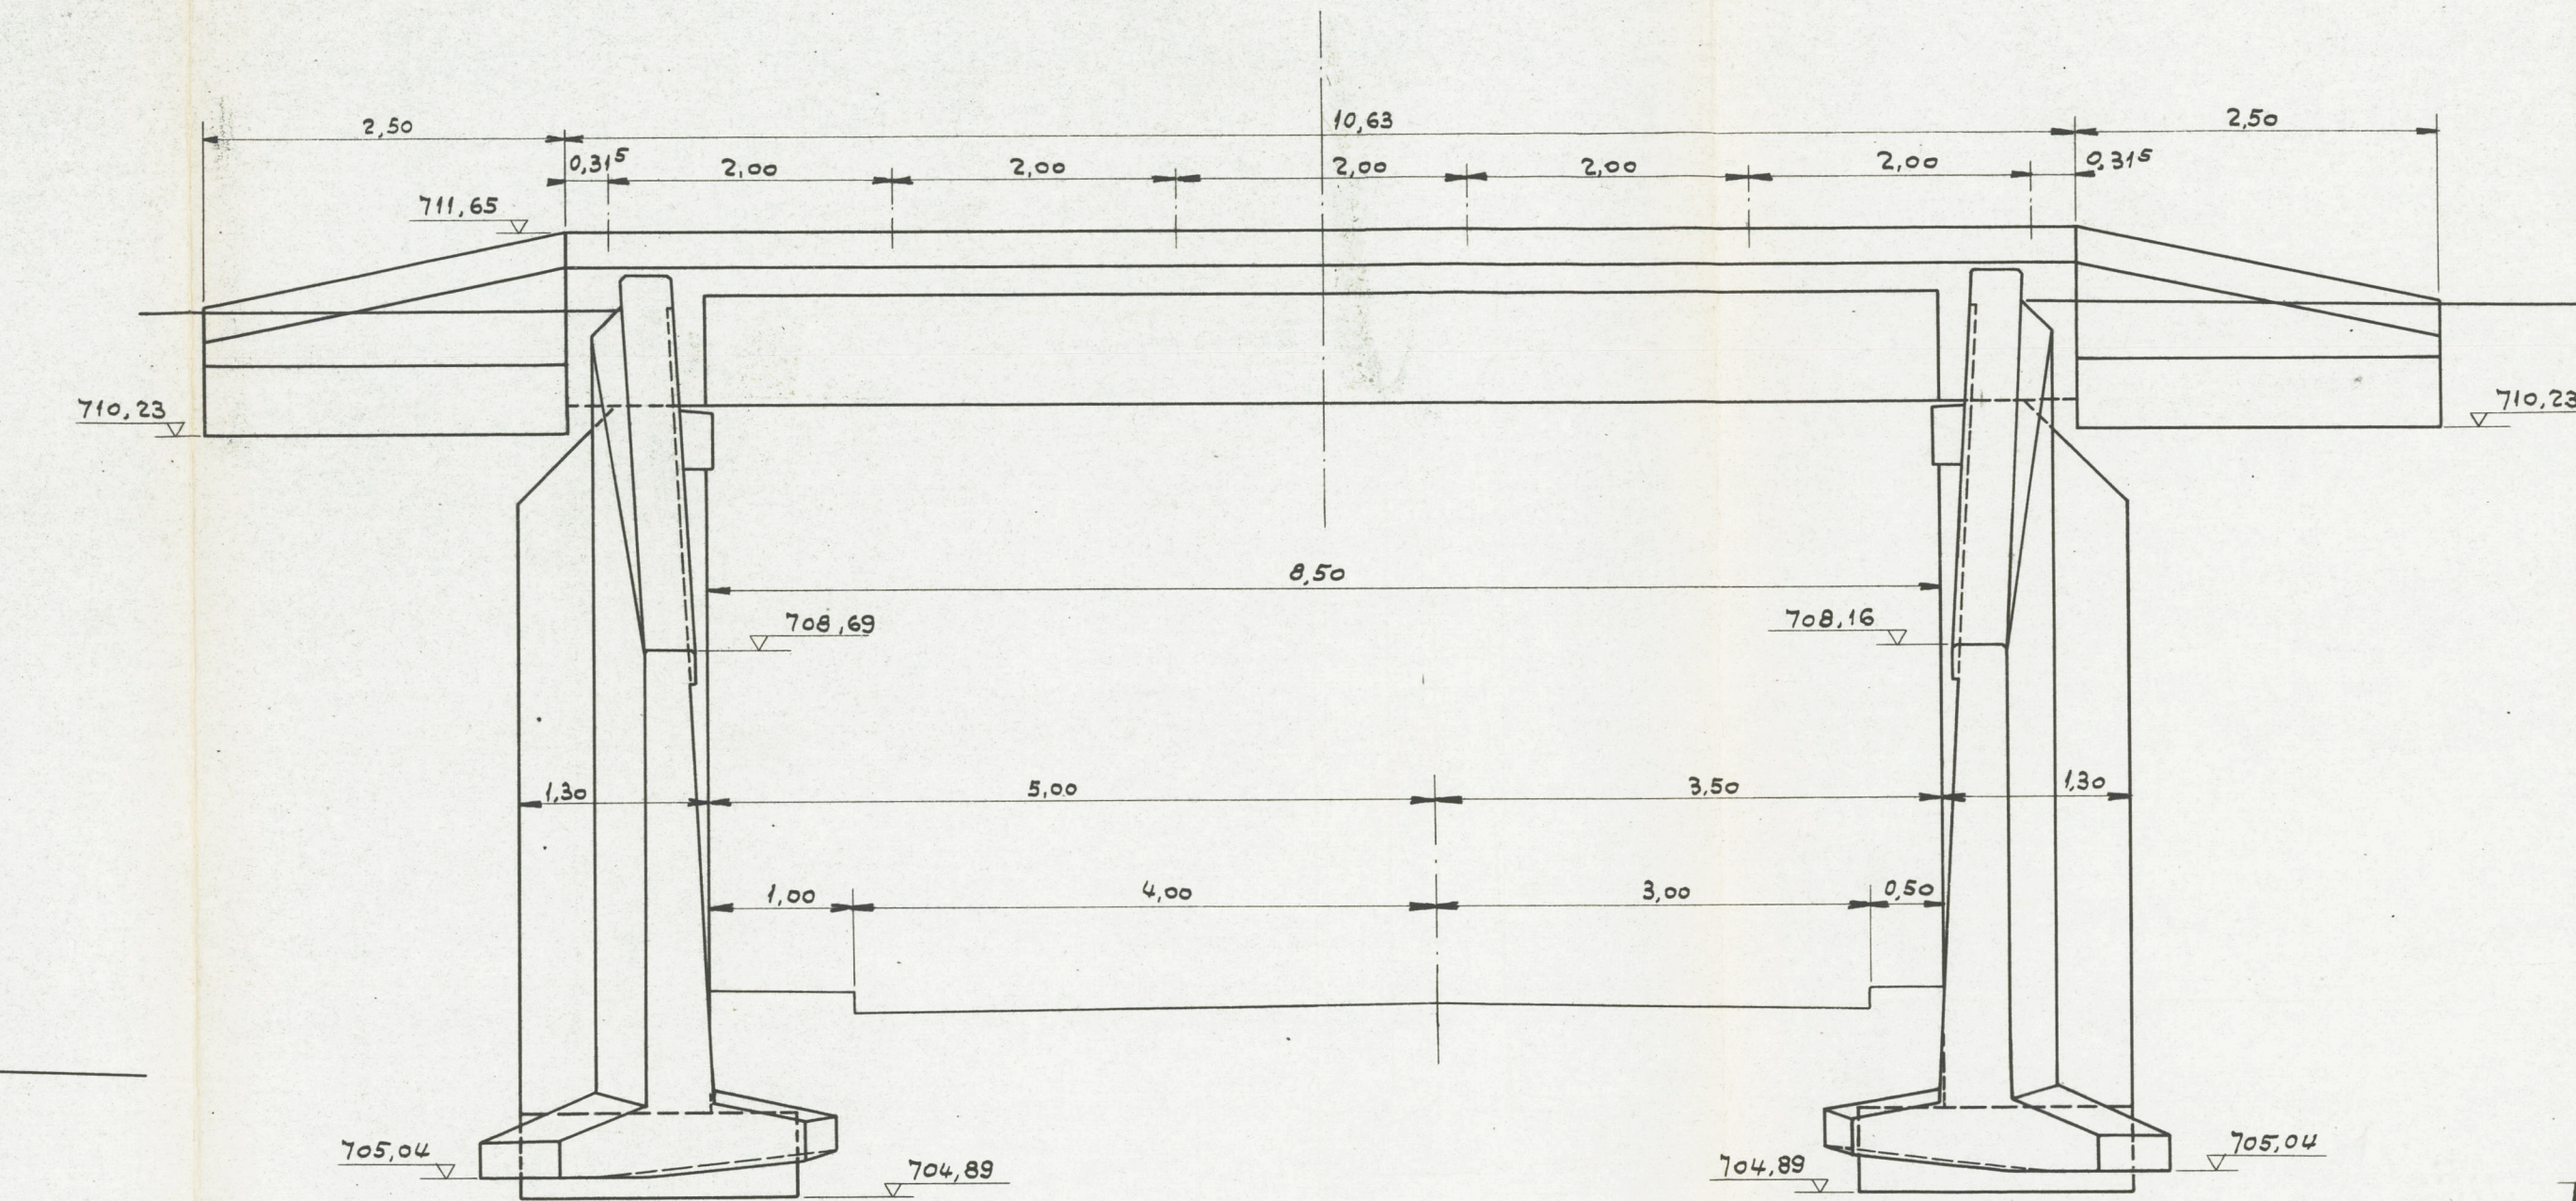

DETAIL E 1:20

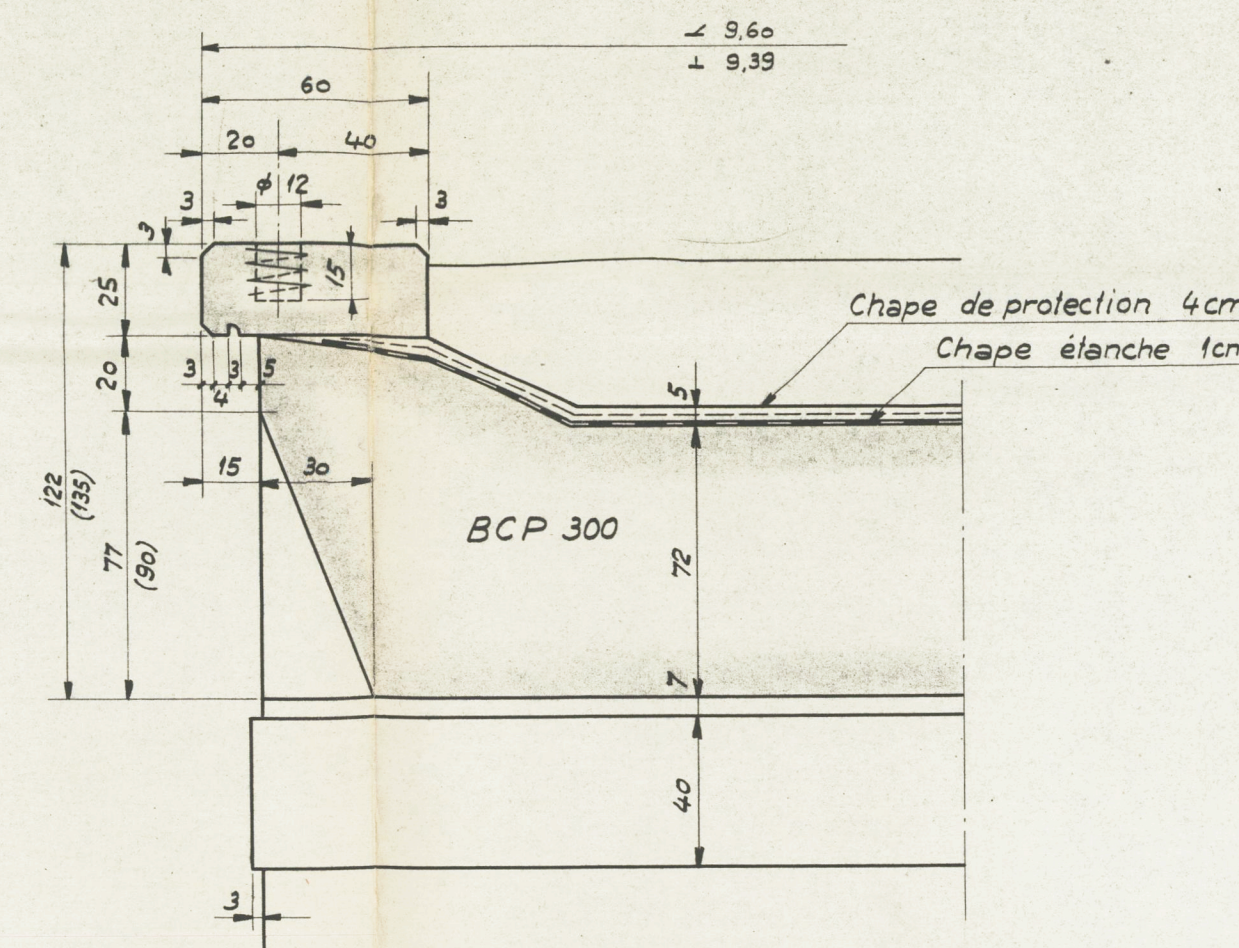

DETAIL F 1:20

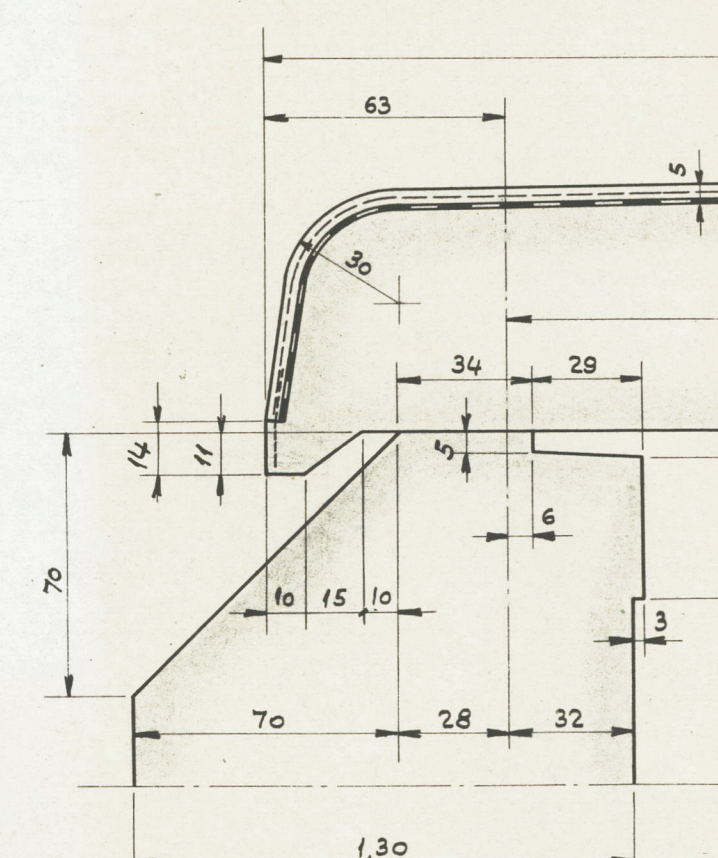

DETAIL G 1:20

